


Splice Rib
 2 places @ 180°
 (to be used for
 option of split
 base)

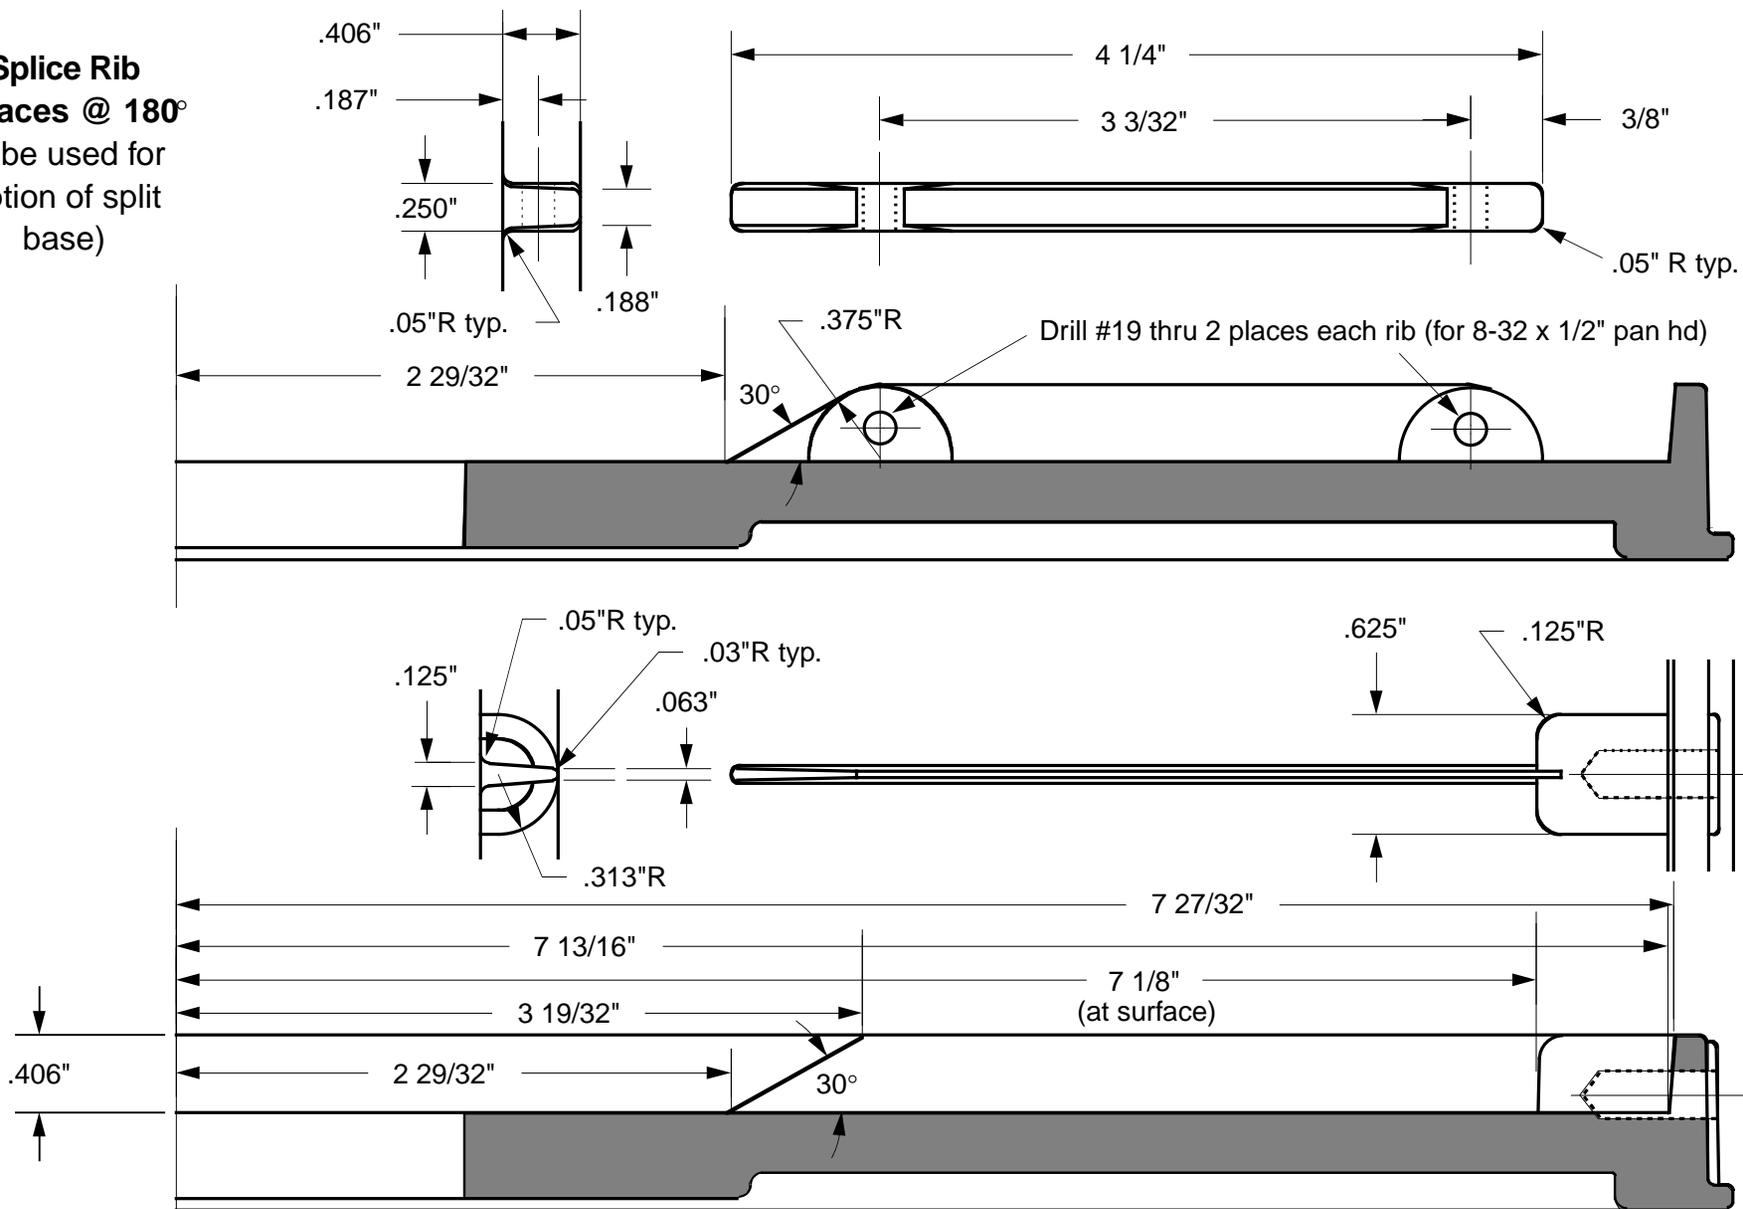

Centerline

Main Rib
 12 places @ 30°

Southern California Integrated GPS Network
 Southern California Earthquake Center
 Los Angeles, California 90089-0742
<http://www.scign.org/>

Tolerances +/- (unless specified)
 x/x .x .xx .xxx angular
 1/64" .1" .01" .005" 1deg

SCIGN Radome Drawings

TITLE
Base Plate Details

DRAWN BY CBH DATE 25 Feb 99
 Do Not Scale This Drawing SCALE 1" = 2.5"

DRAWING NUMBER
DSP-004